


EXISTING LEVEL 3 (first floor)
SCALE 1:100

- TO DEMOLISH
- TO CONSTRUCT
- AS BUILT TO SANCTION
- AS APPROVED, NOT CONSTRUCTED

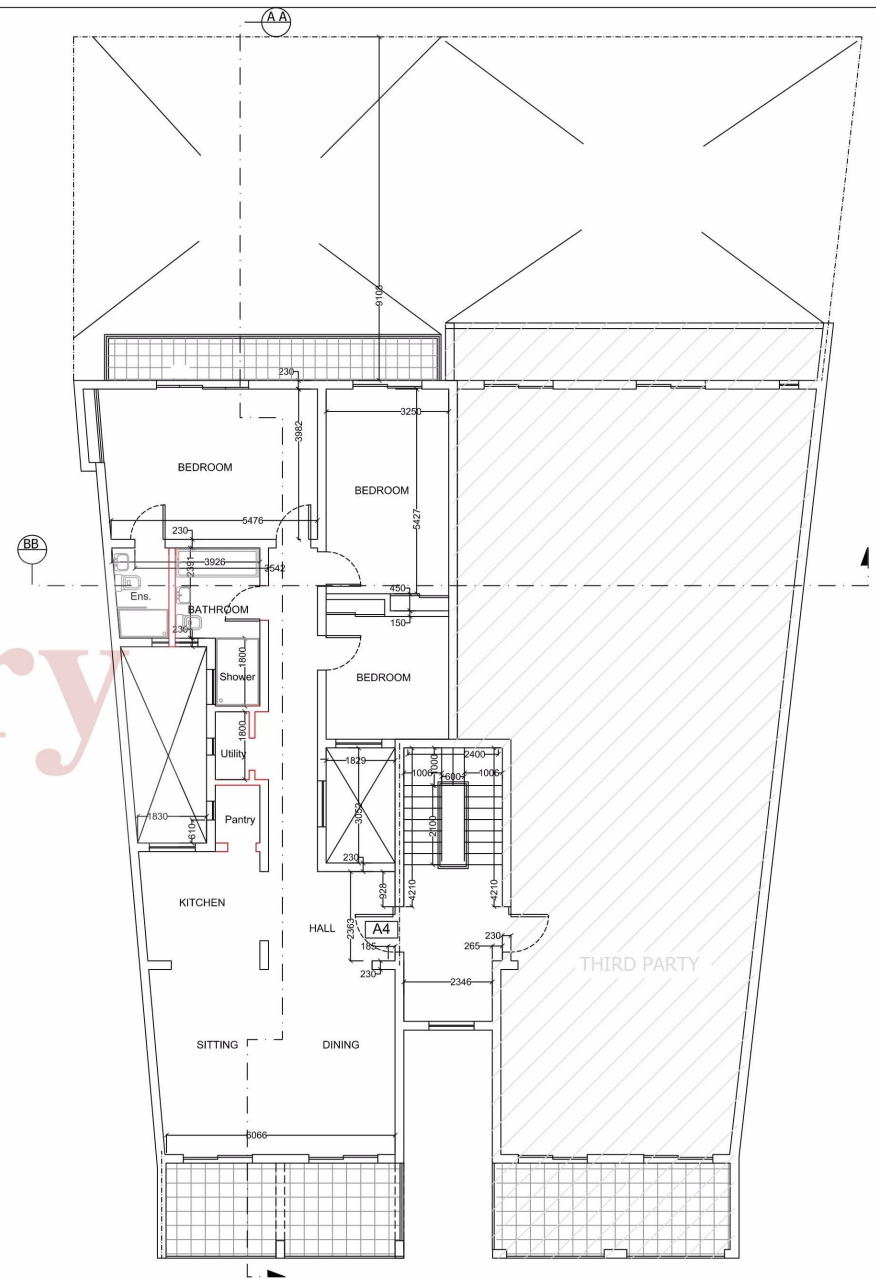

A4
Gross floor area 177 sqm
Internal area 150 sqm
External area 27 sqm

PROPOSED LEVEL 3 (first floor)
SCALE 1:100

