



SCALE 1:100

LEGEND

- APPROVED PA/5441/98
- TO CONSTRUCT
- TO DEMOLISH
- AS BUILT
- AS APPROVED BUT NOT BUILT

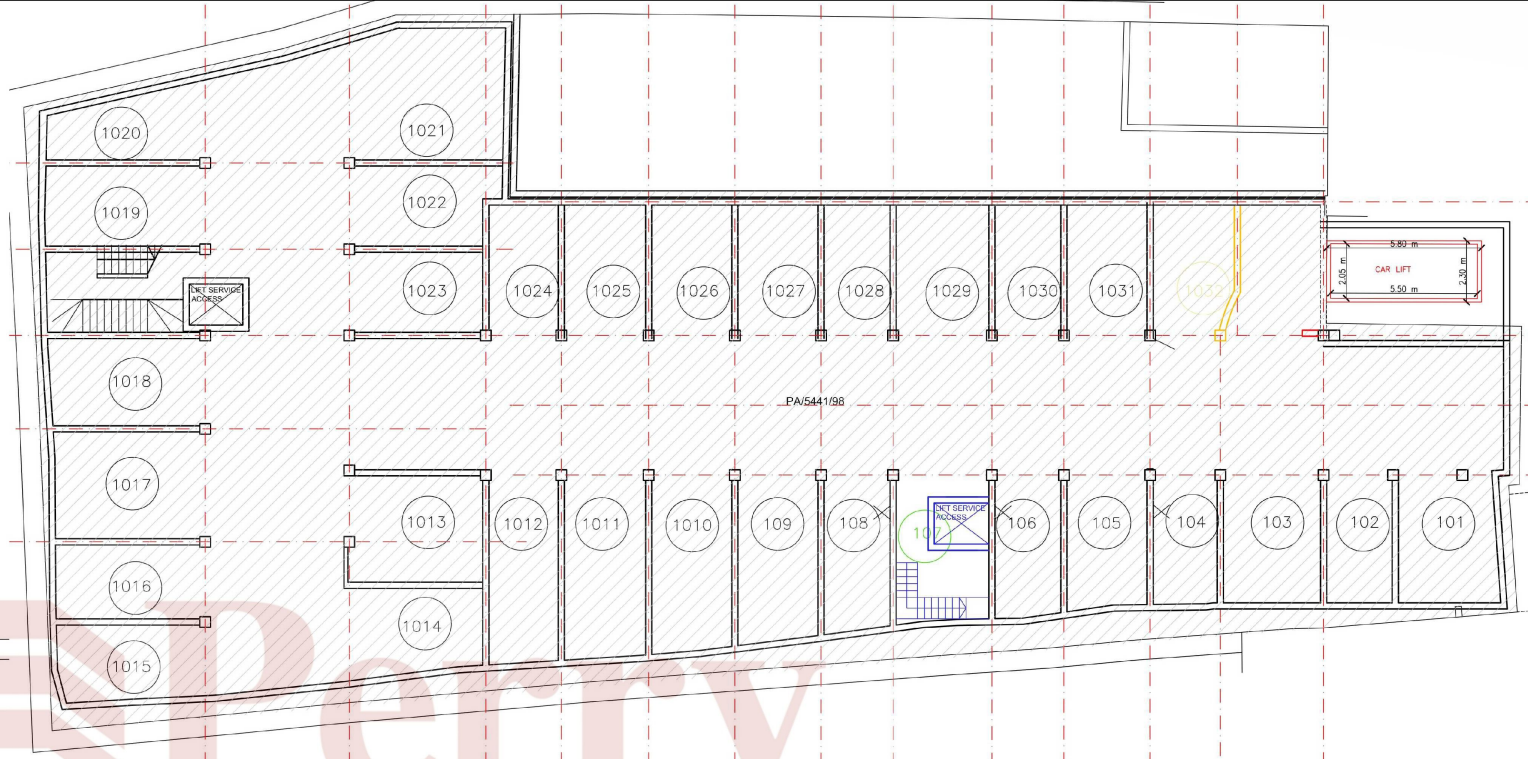

PLAN LEVEL B2

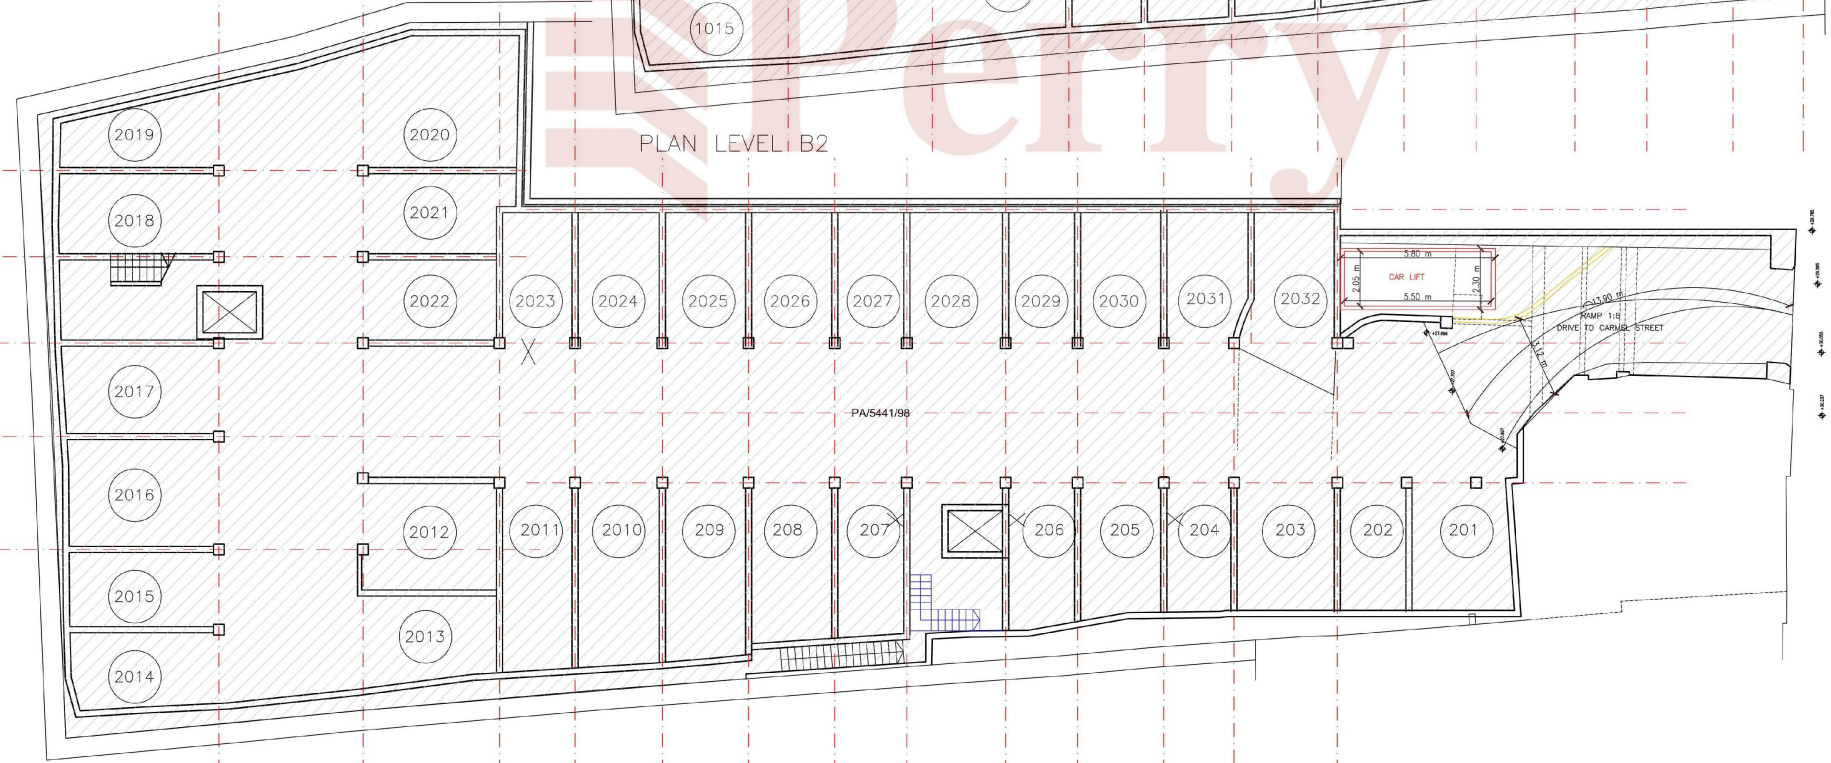

PLAN LEVEL B1

↑ 0.000  
↑ 0.000  
↑ 0.000