


**ELEVATION**  
scale 1:50

**Facade materials:**


Franka stone masonry unpainted;  
natural timber apertures;  
wrought iron railings and security  
grid painted black

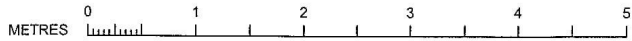

SCALE 1:50

METRES 1 0 1 2 3 4 5 6 7 8 9 10


SCALE 1:100

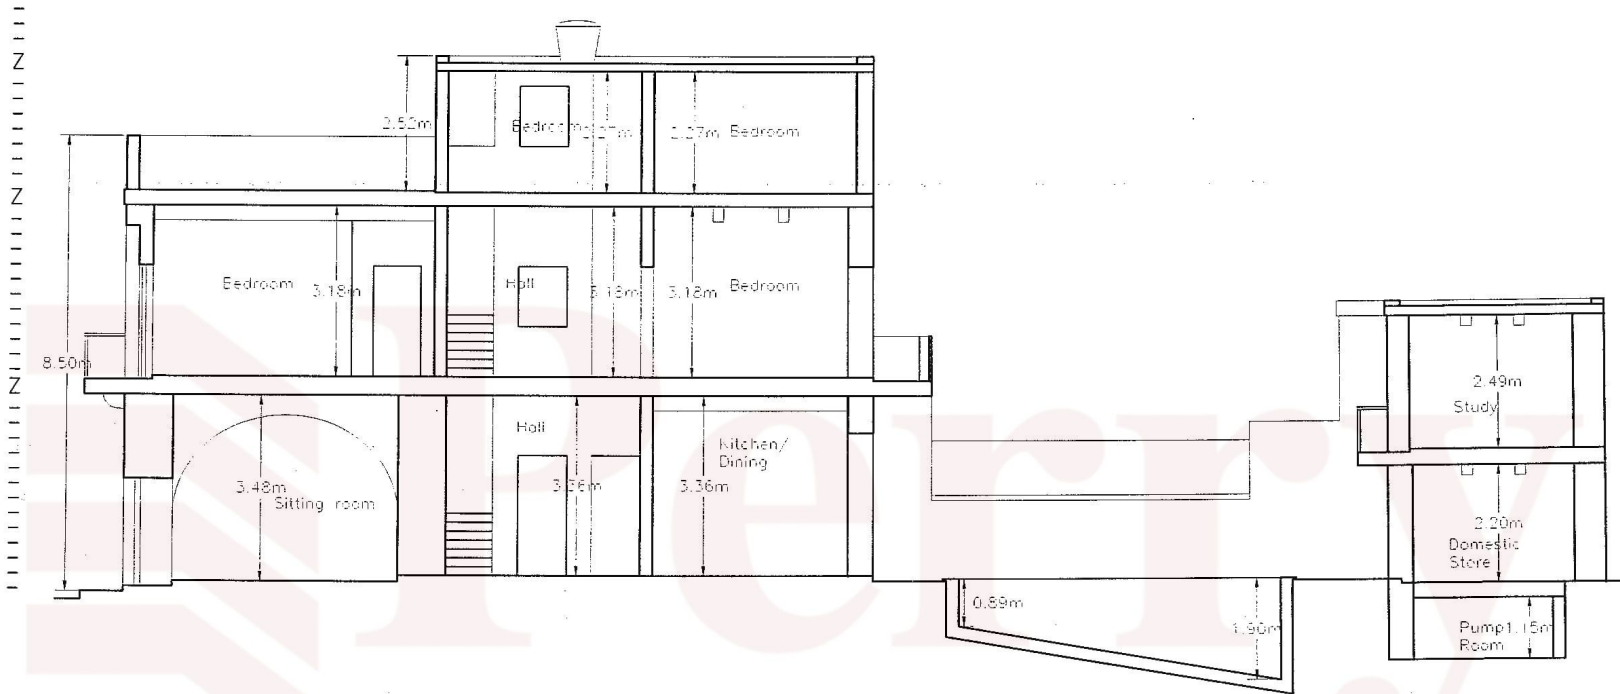


**SECTION AS BUILT**  
scale 1:100

METRES 1 0 1 2 3 4 5 6 7 8 9 10


SCALE 1:100

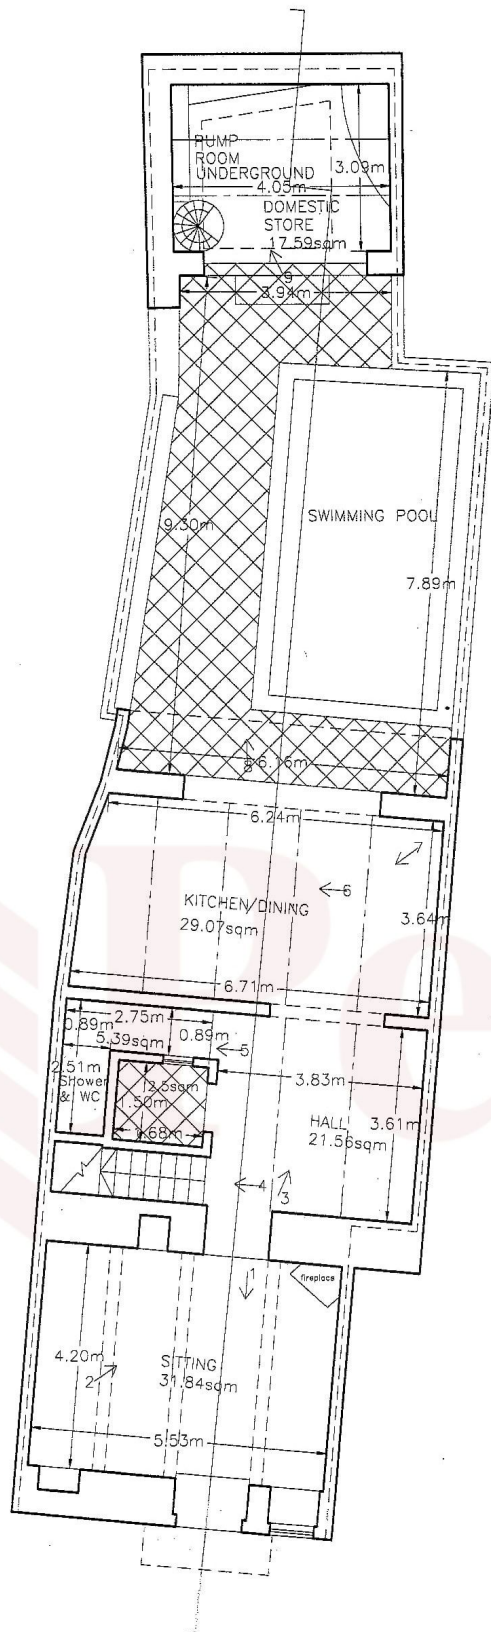

**GROUND FLOOR**  
 scale 1:100  
 Roofed area of ground floor: 114.19sqm

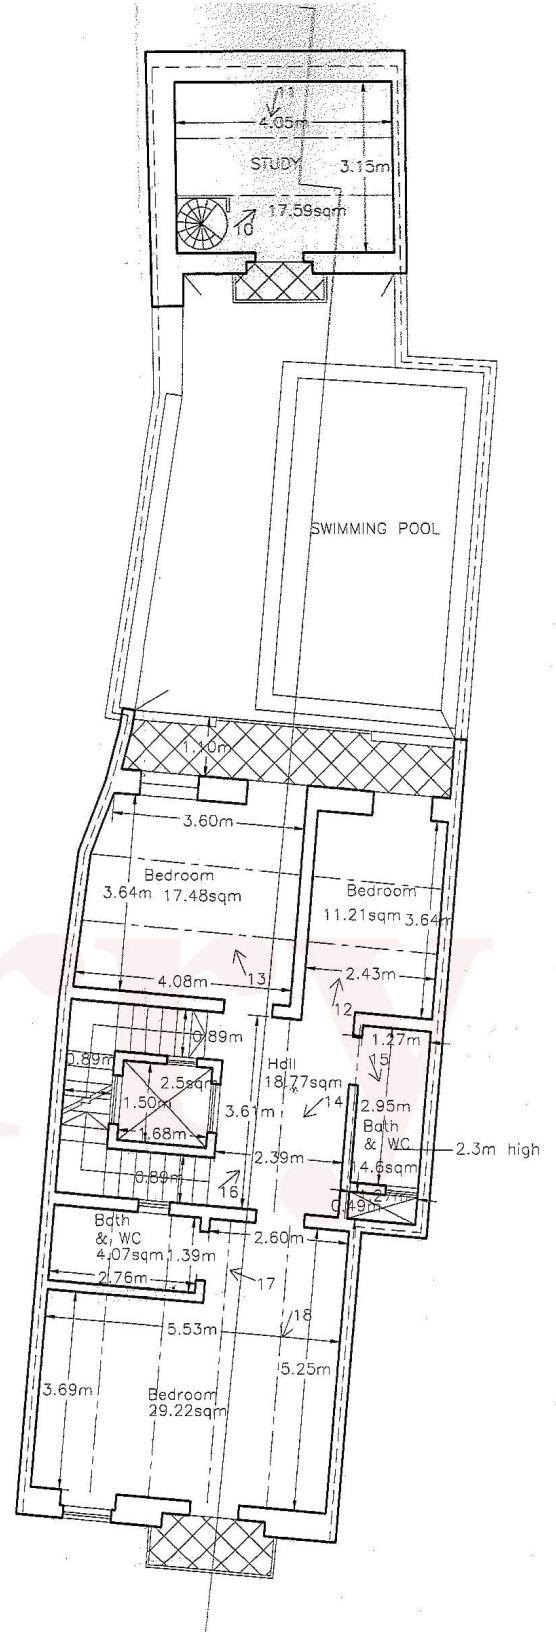


**FIRST FLOOR**  
 scale 1:100  
 Roofed area of first floor: 103.5sqm

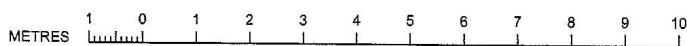


SCALE 1:100

Total roofed area of terraced house: 253.94sqm

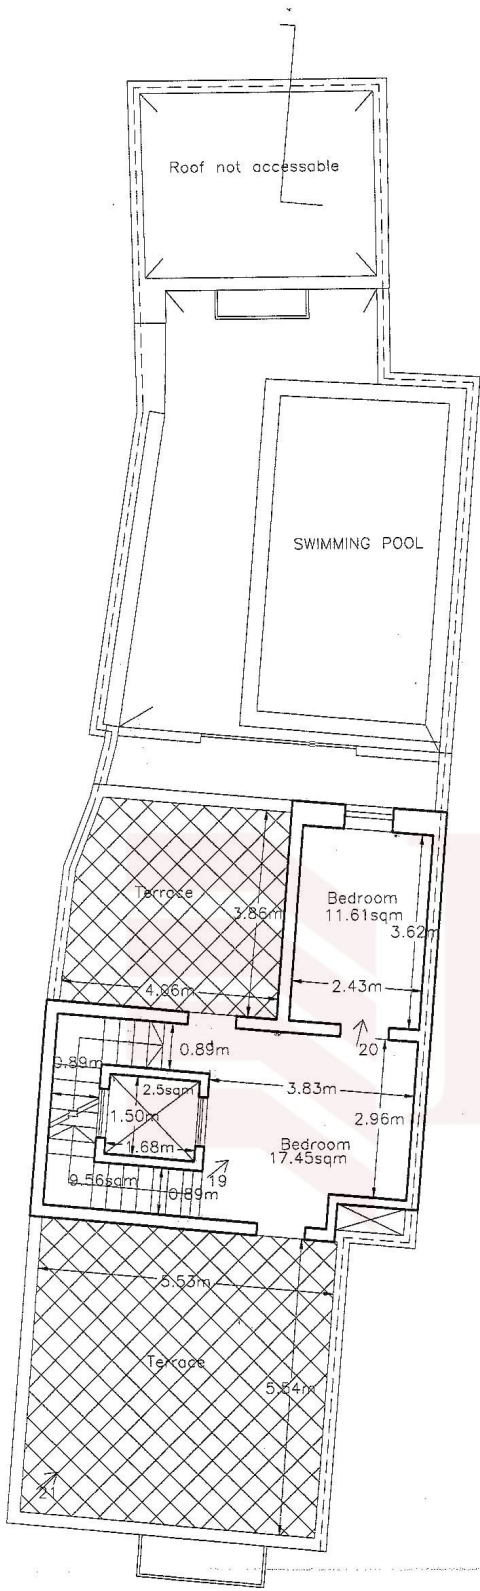

**Second Floor**

scale 1:100  
 Roofed area of second floor: 36.25sqm

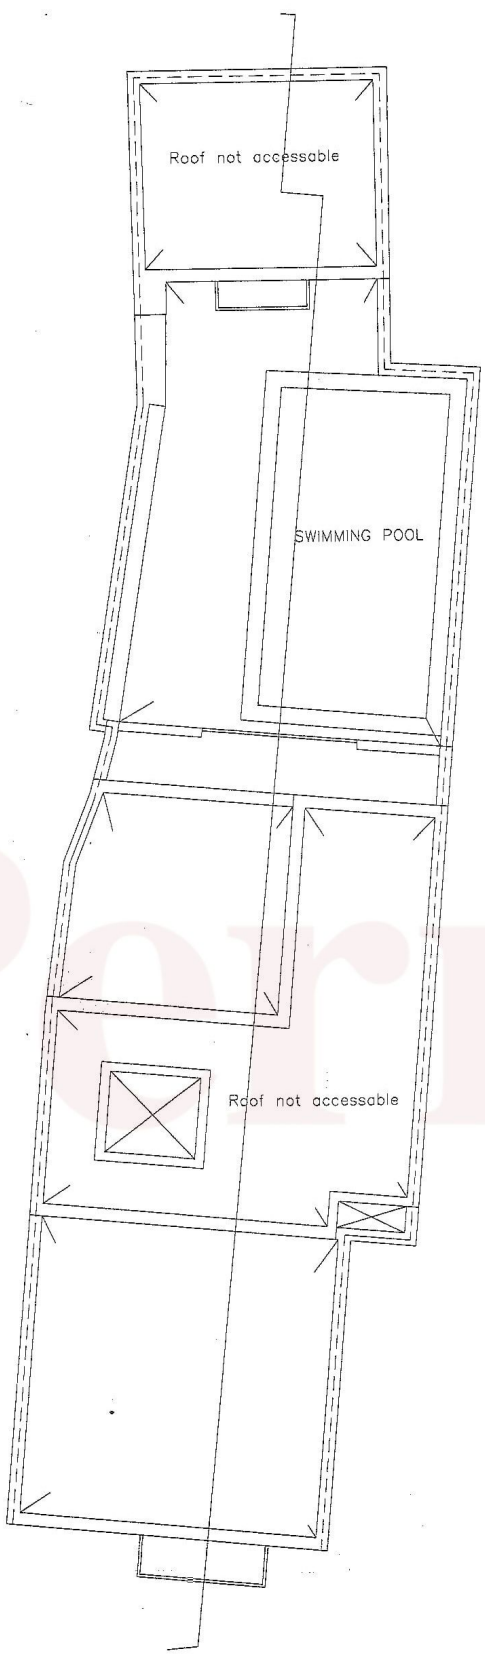

**Roof Level**

scale 1:100