
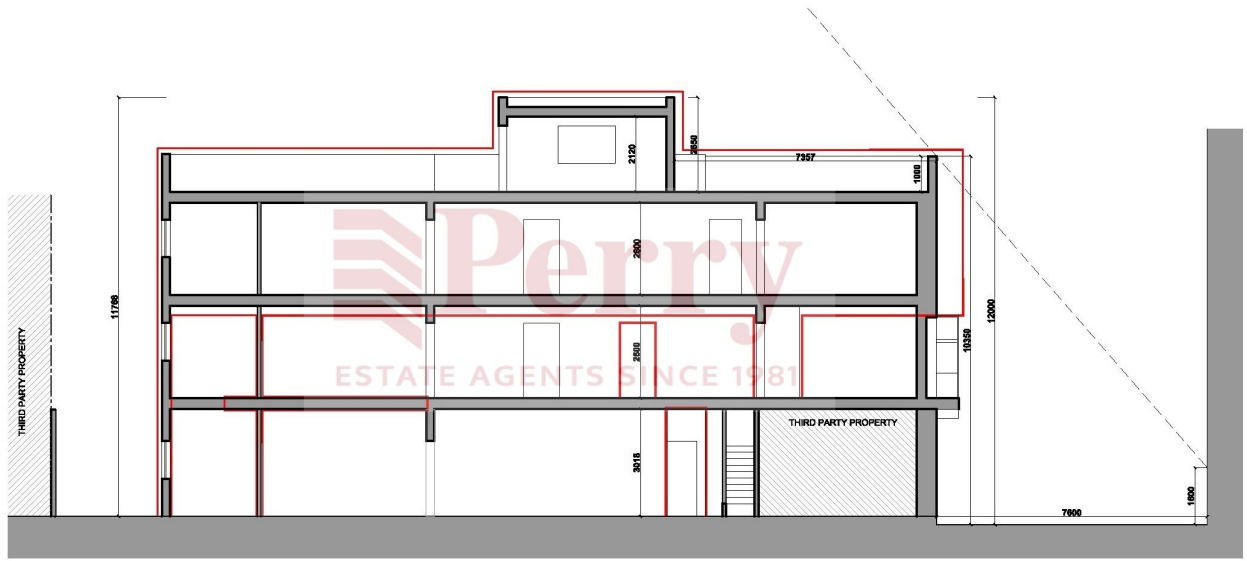


HT500021

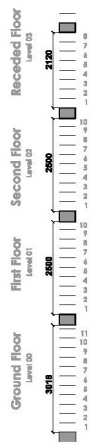

Proposed Section A-A'
Scale 1:100

- LEGEND**
- As Existing
 - As Proposed
 - As Approved
 - As Constructed