


Ceiling Opening in Ramp  
Grill




**As Approved**  
scale 1:100

**As Proposed Basement Level**

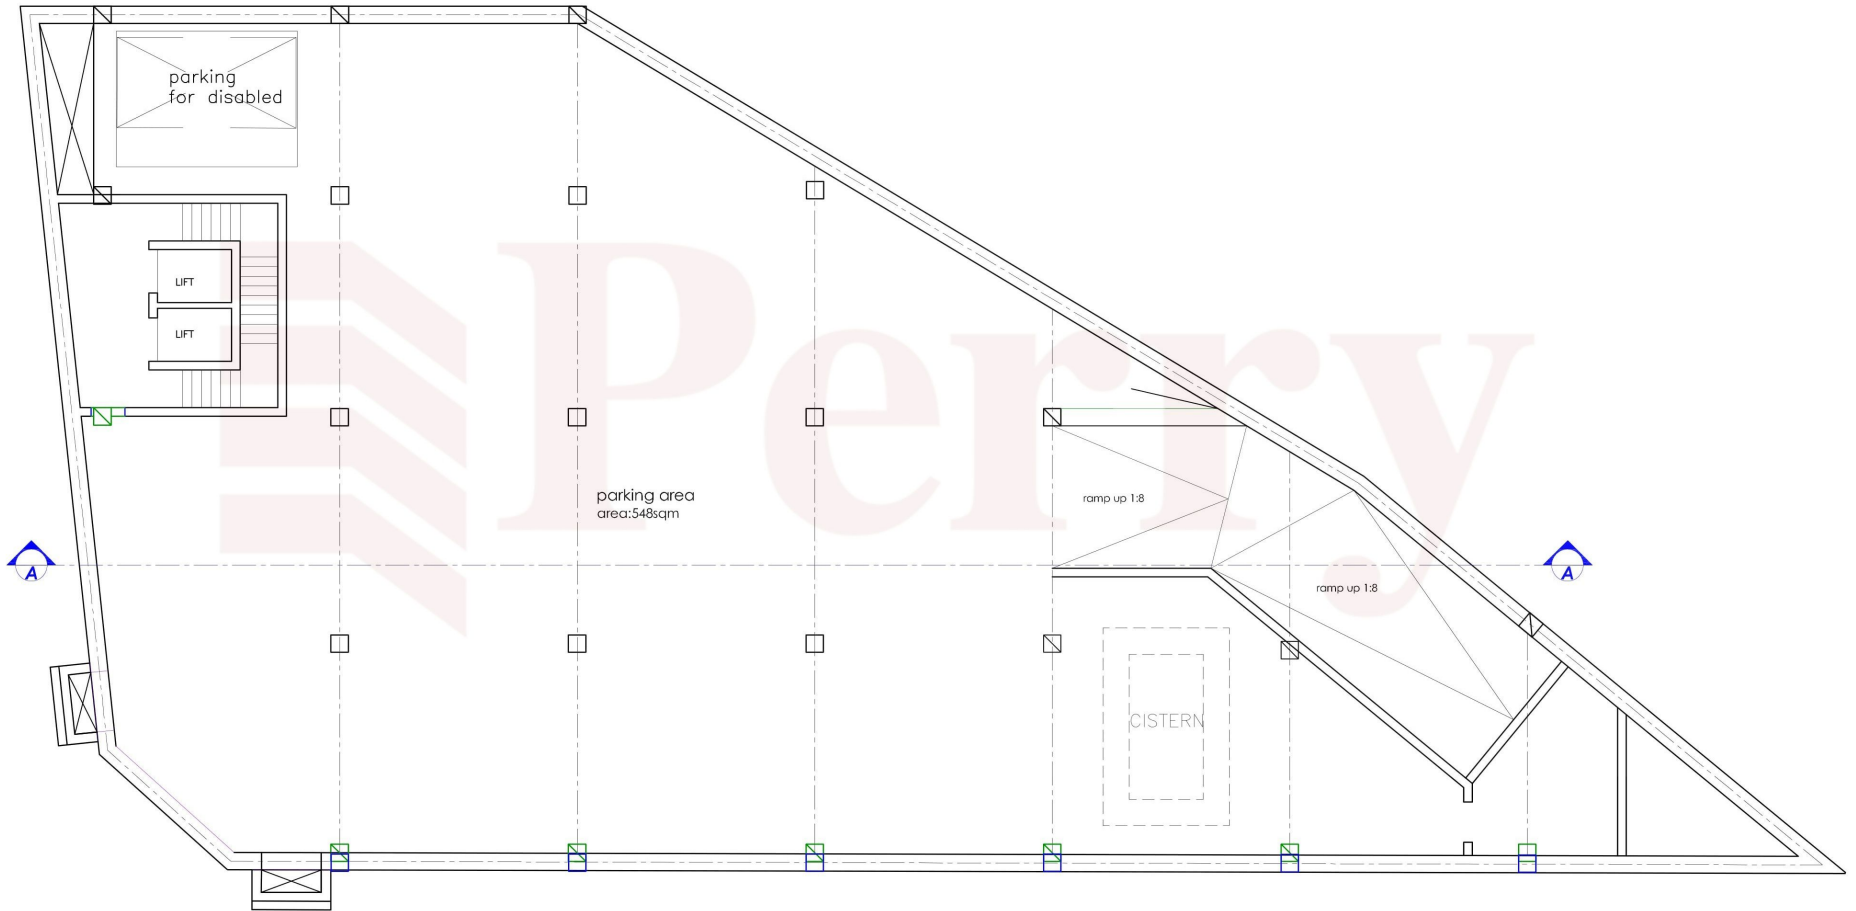

 **As Approved**  
 **As Constructed**

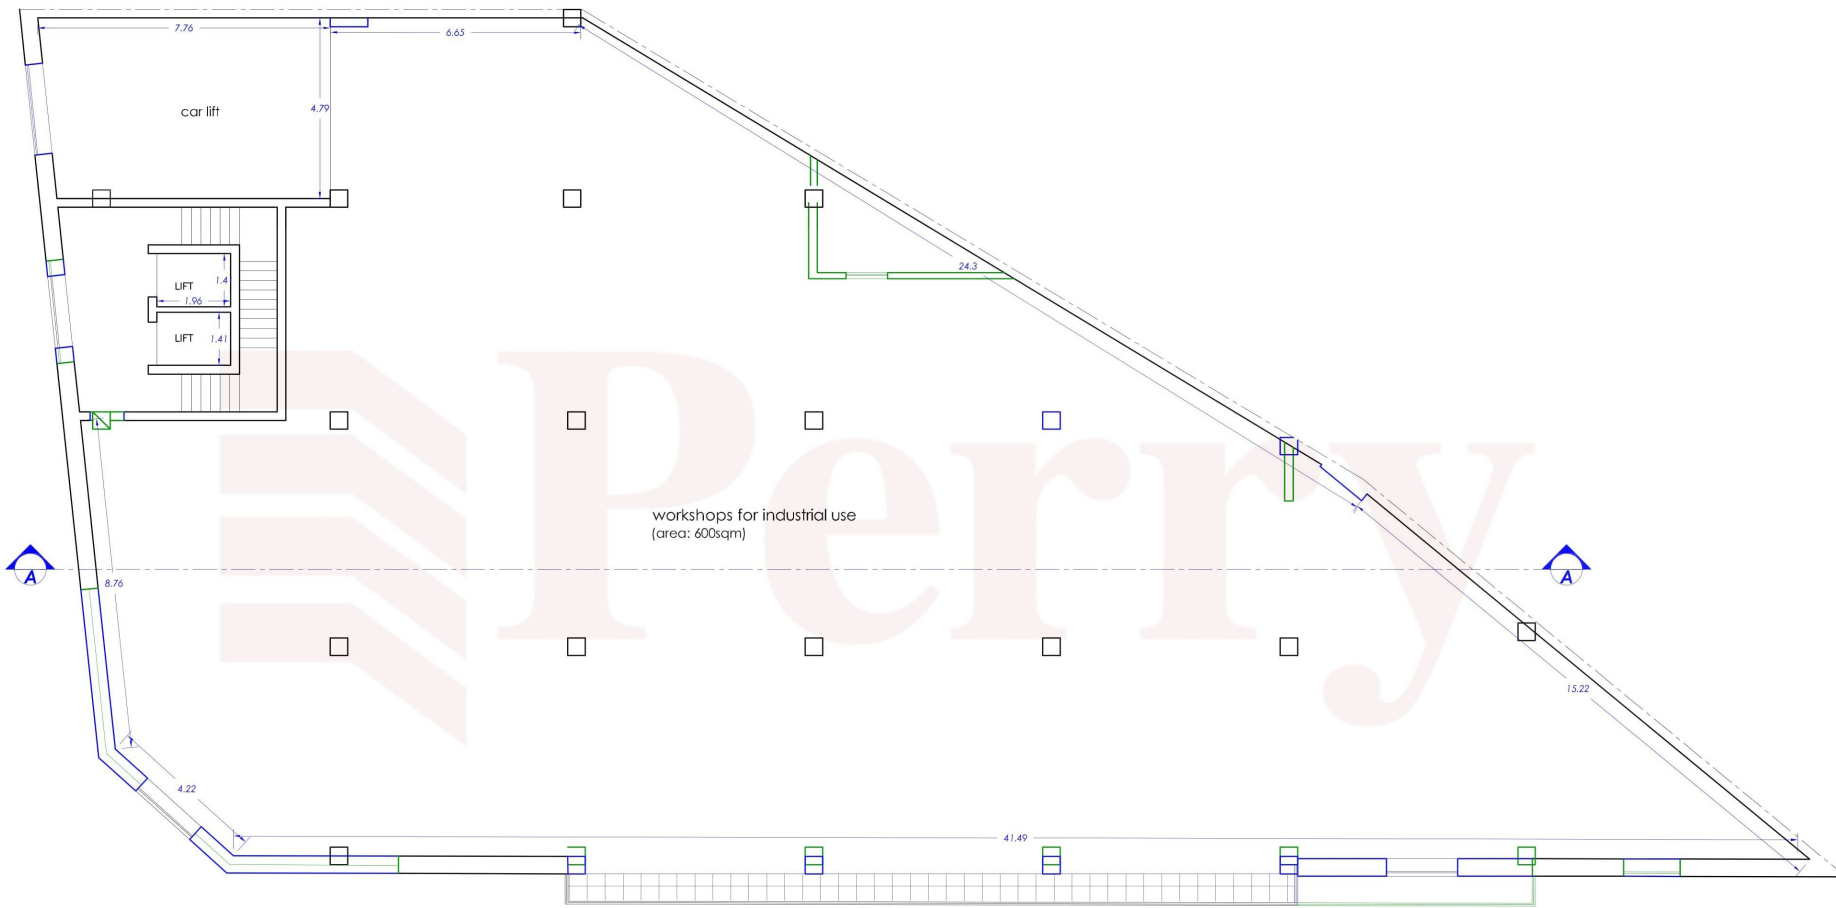


**As Approved**  
scale 1:100

**As Proposed Second Floor Level**



As Approved  
 As Constructed

Ceiling Opening in Ramp  
Grill

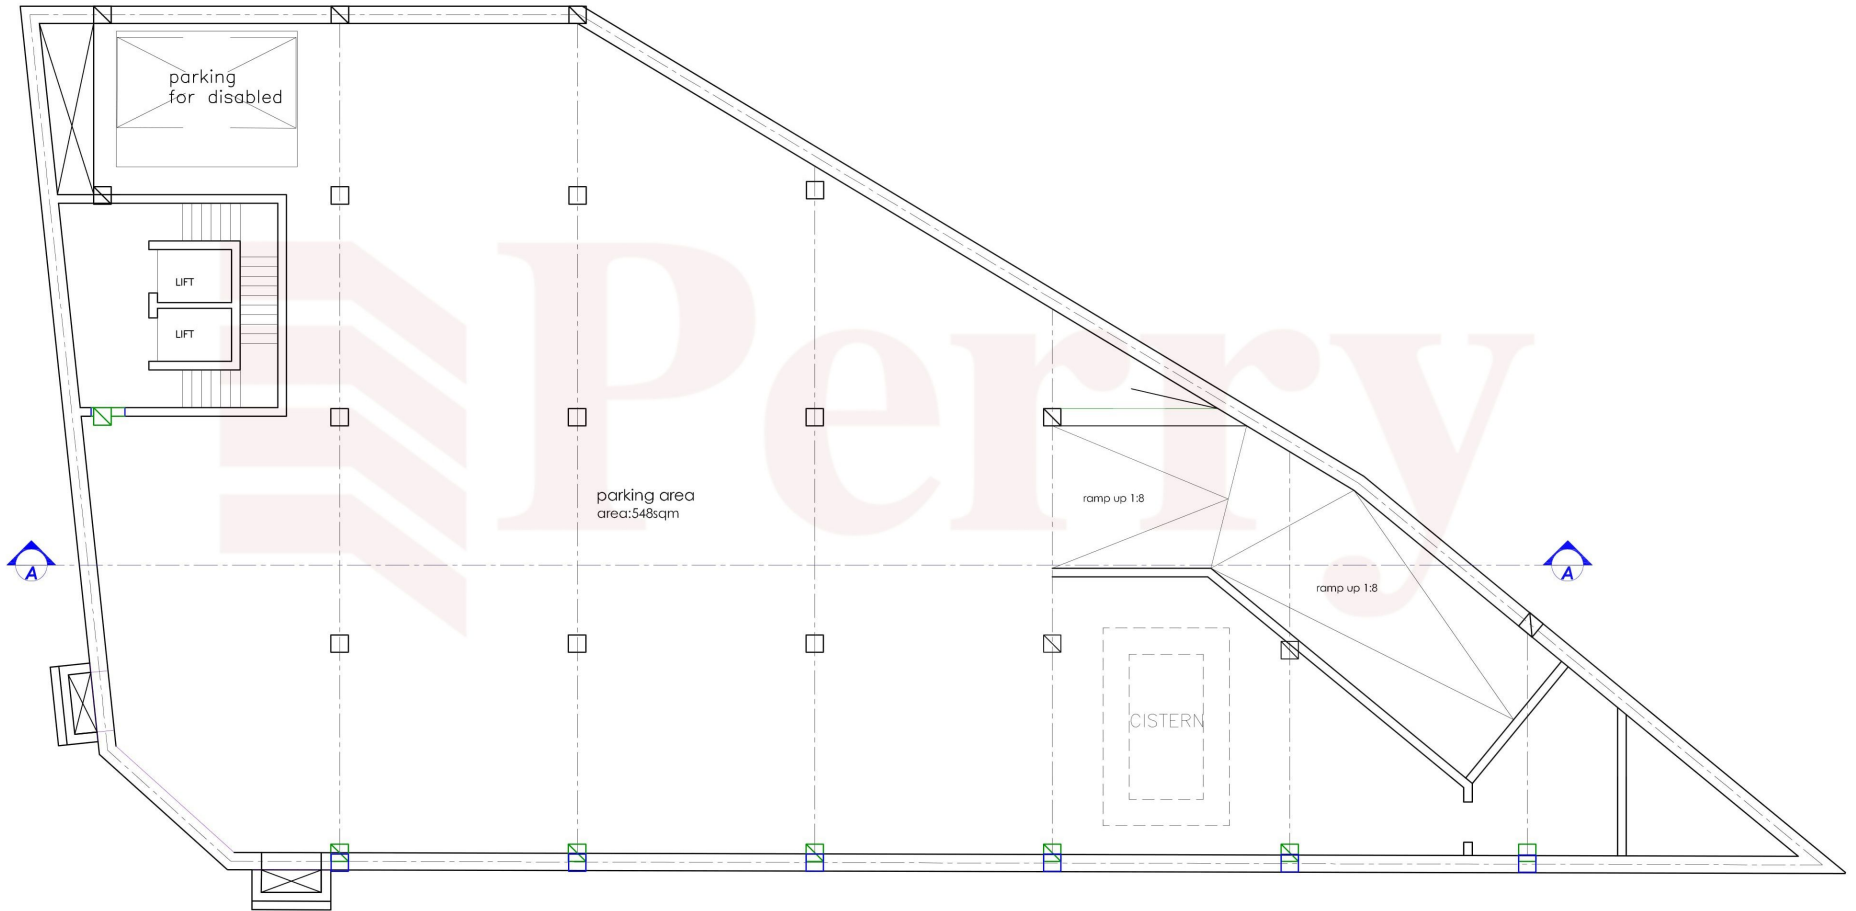


**As Approved**  
scale 1:100


**As Proposed Basement Level**




As Approved  
As Constructed

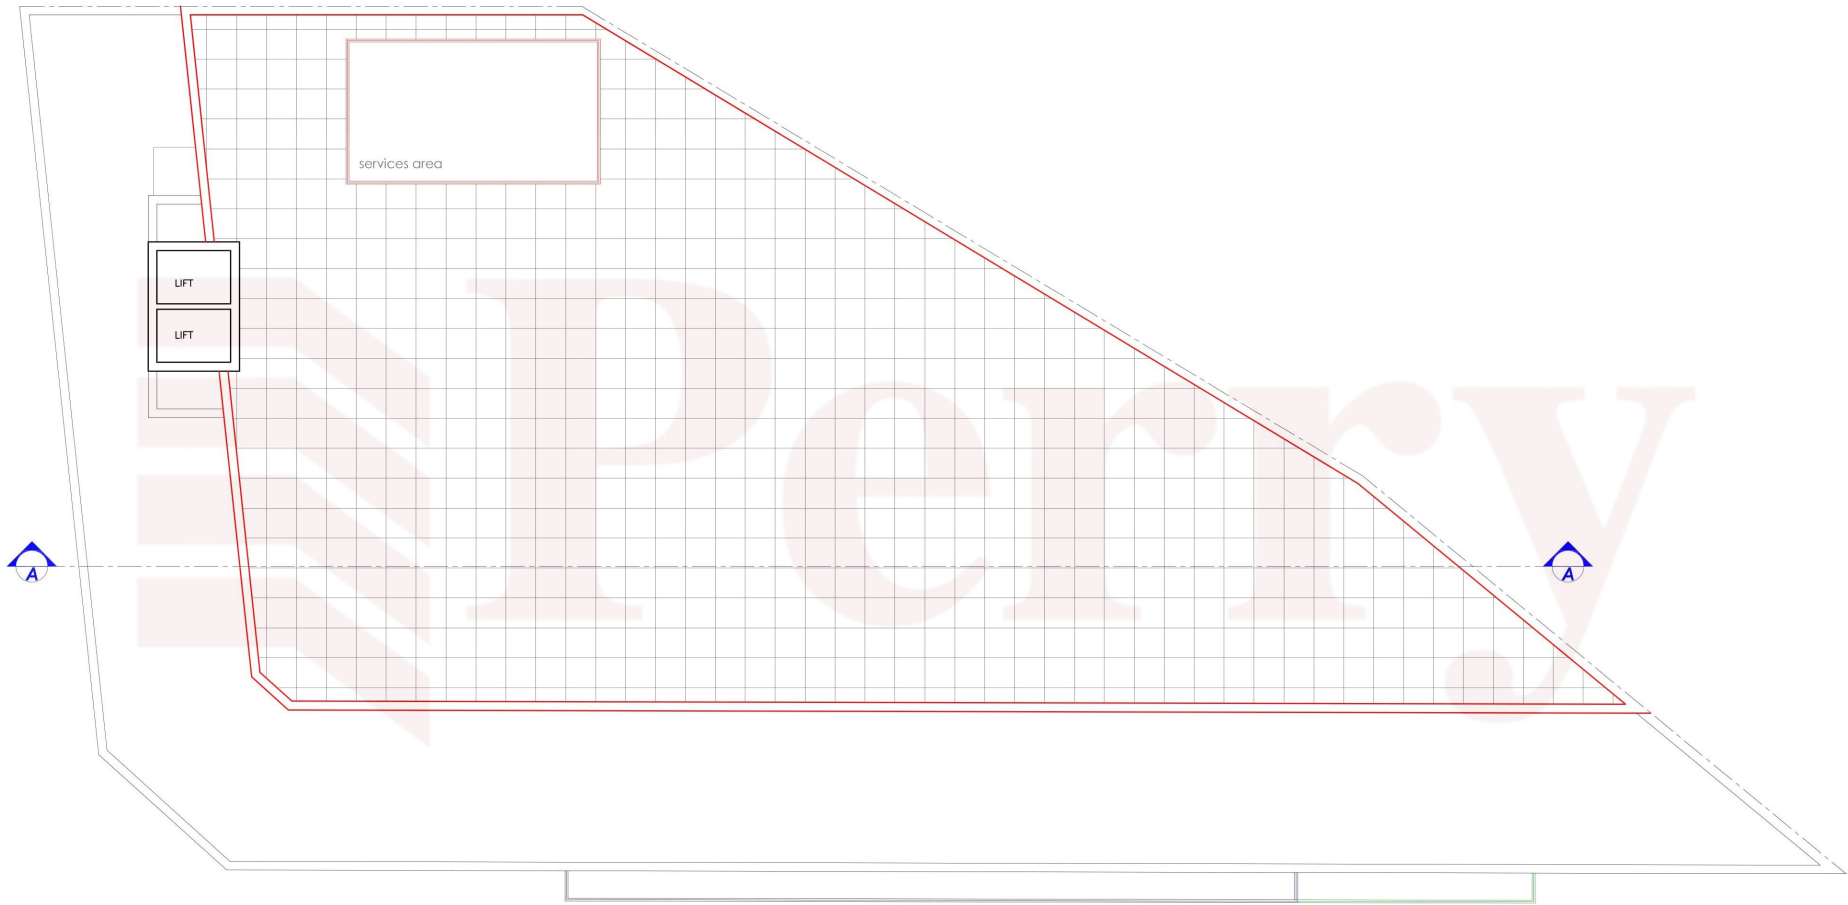

**Proposed Alterations on Roof Level**  
scale 1:100

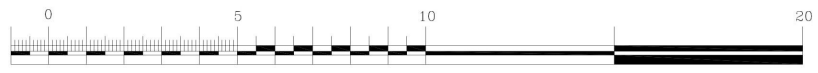

-  As Approved
-  As Constructed

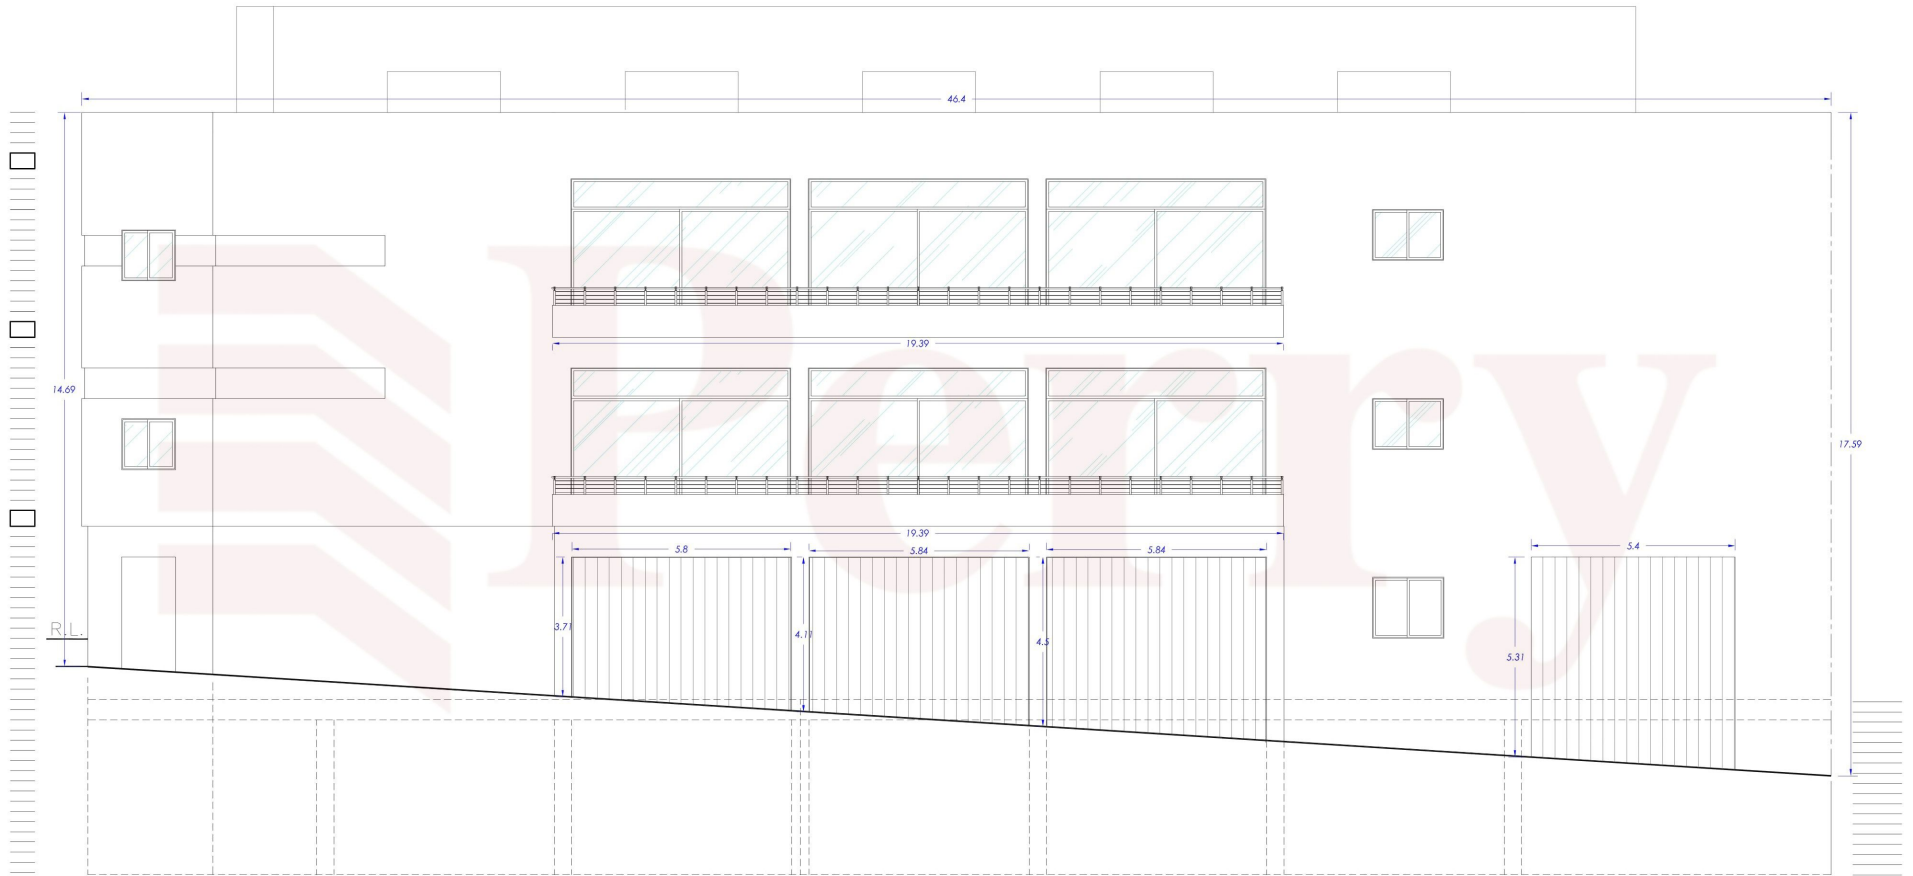


**Front Elevation**  
scale 1:100


clean copy

Note:


- All apertures are to be in black aluminum
- Railing is to be in black aluminum
- Facade to be in graffiato stone colour
- Garage doors in to be in steel

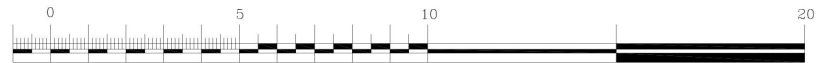

- As Approved
- As Constructed

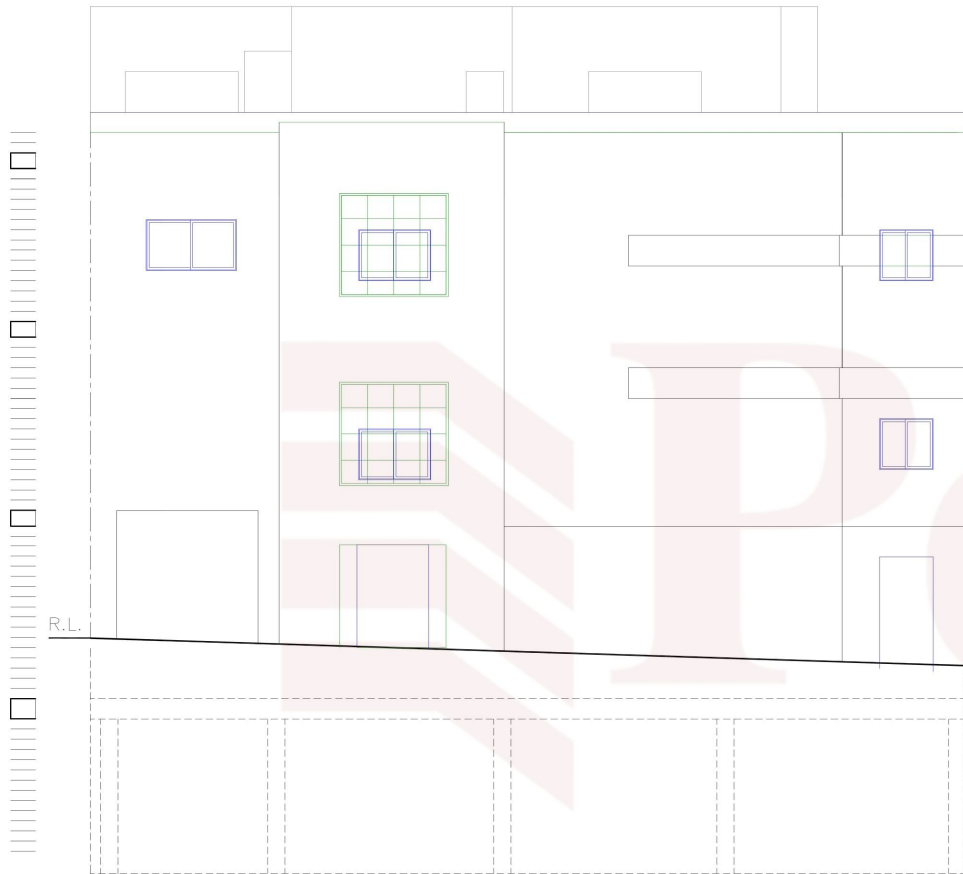

**Proposed Alterations on Side Elevation**  
scale 1:100

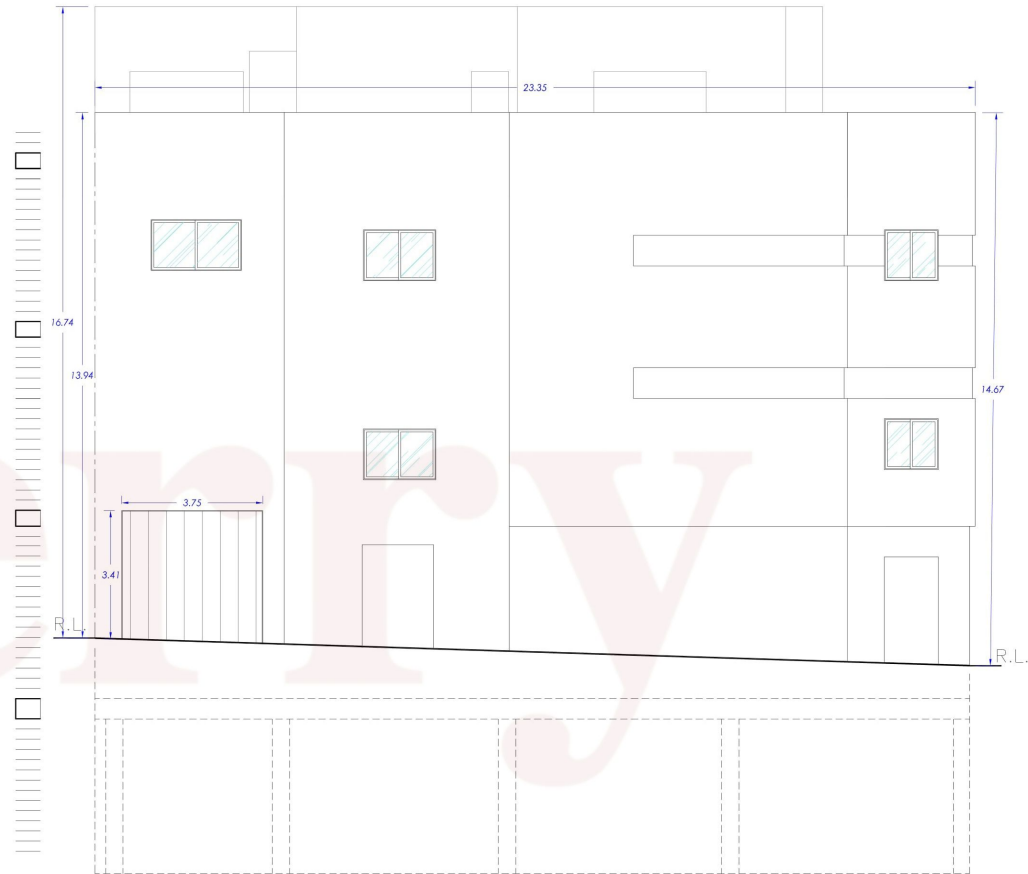


**Side Elevation**  
scale 1:100

clean copy

SIDE ELEVATION

- Note:
- All apertures are to be in black aluminum
  - Railing is to be in black aluminum
  - Facade to be in graffiato stone colour
  - Garage doors in to be in steel

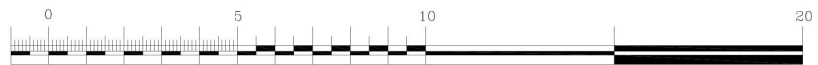

- As Approved
- As Constructed