


Applicant has right to open new apertures onto the common forecourt to internal garages

NOTE:
All doors are to have a clear opening width of not less than 900mm.

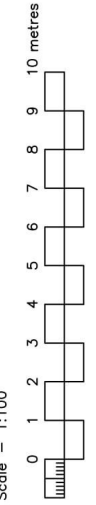

RECEDED FLOOR PLAN
Built up Area = 379.95sq.m.

LEGEND:

- as constructed, to sanction
- approved but not constructed