



A

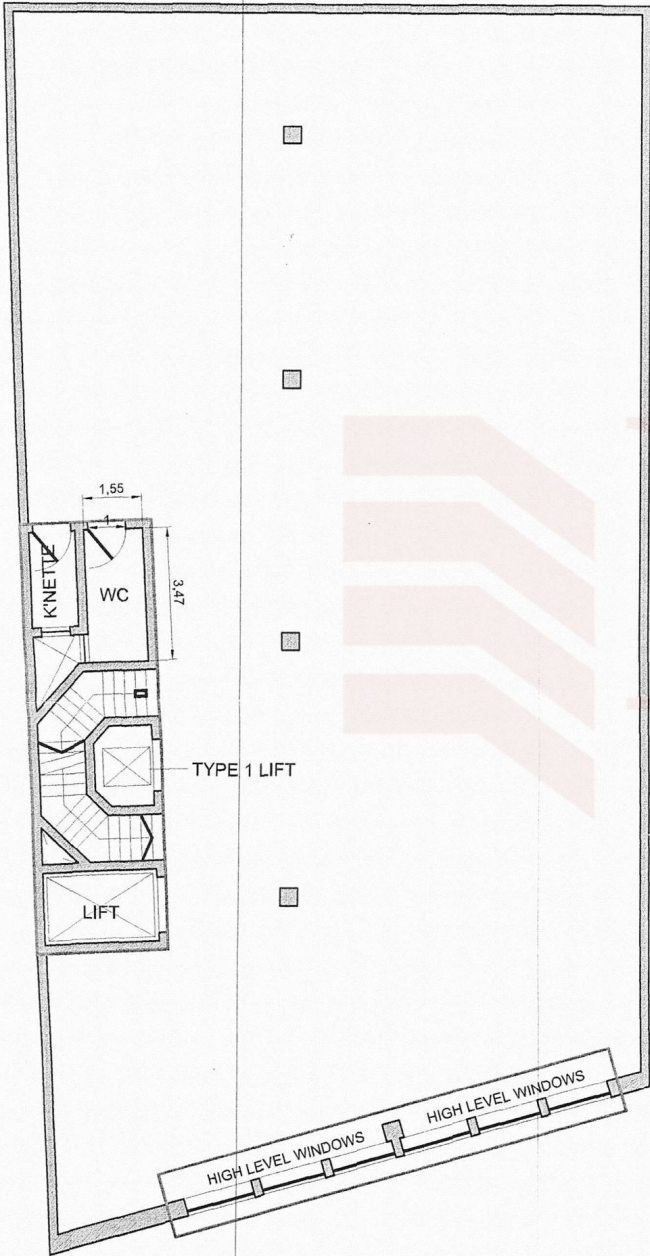

EXISTING BASEMENT LEVEL

A

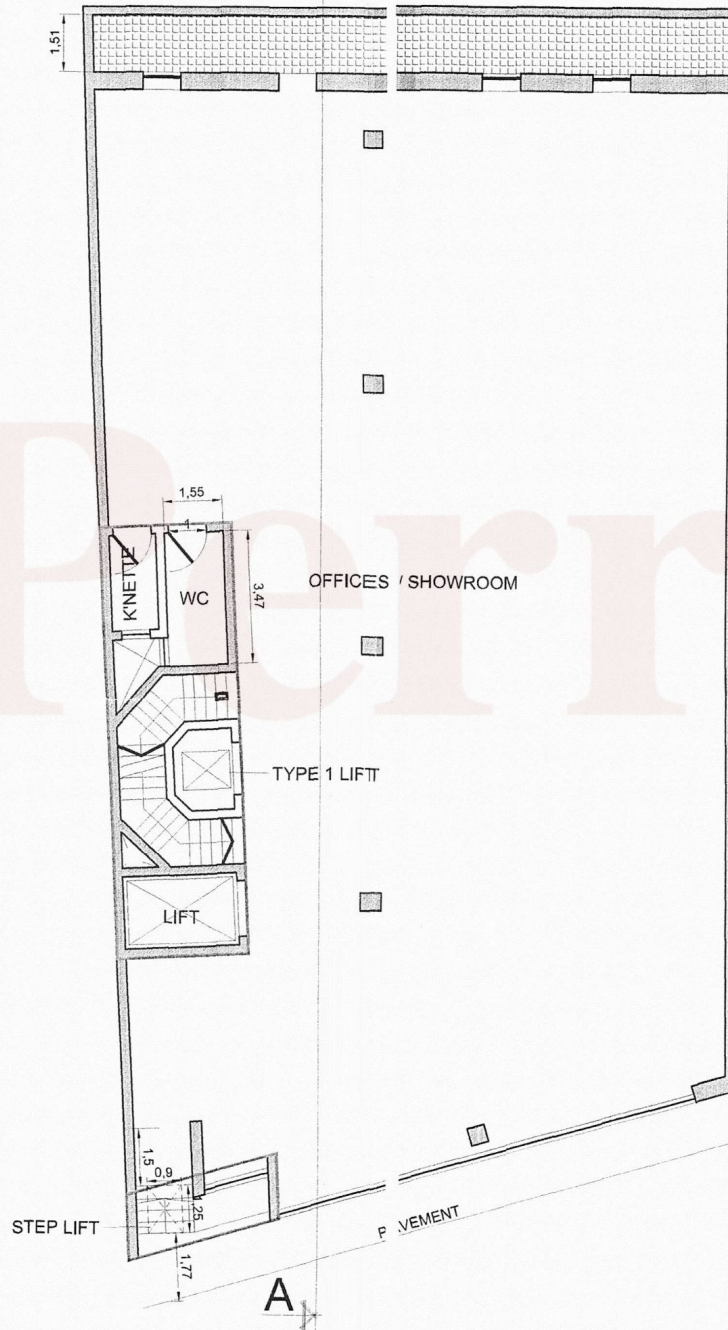

EXISTING GROUND FLOOR LEVEL

AS CONSTRUCTED

