


**APPROVED GARAGE (Street Level)**

Scale:- 1:100





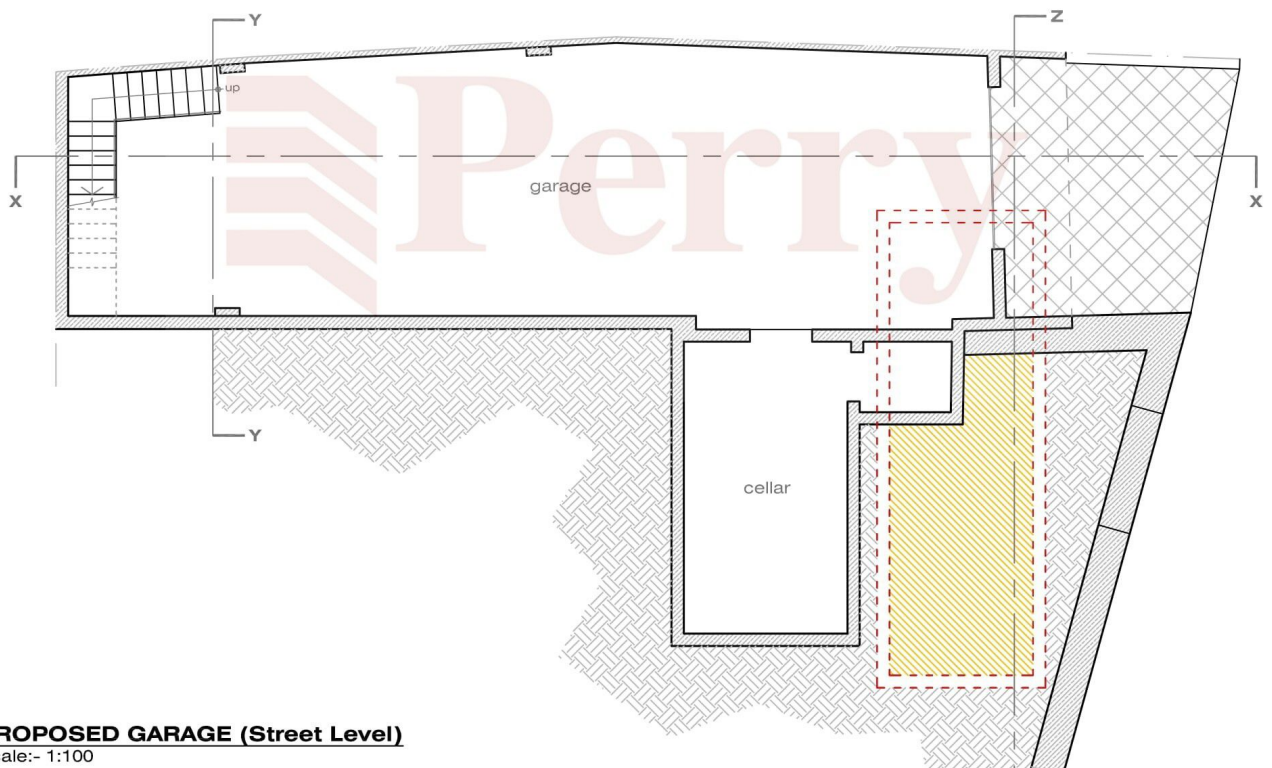


**PROPOSED GARAGE (Street Level)**

Scale:- 1:100




Scale:- 1:100


Color Coding Legend				
		PROPOSAL	Existing Plans KAPPARA	
	Proposed, to Demolish	CLIENT		
	Proposed, to Construct	SCALE:  1:100	DRAWING NUMBER:  01	REVISIONS
	Sanction, as Constructed	DATE:		
	Approved, Not Constructed	DRAWN BY:	JOB NUMBER:	PAPER SIZE A2

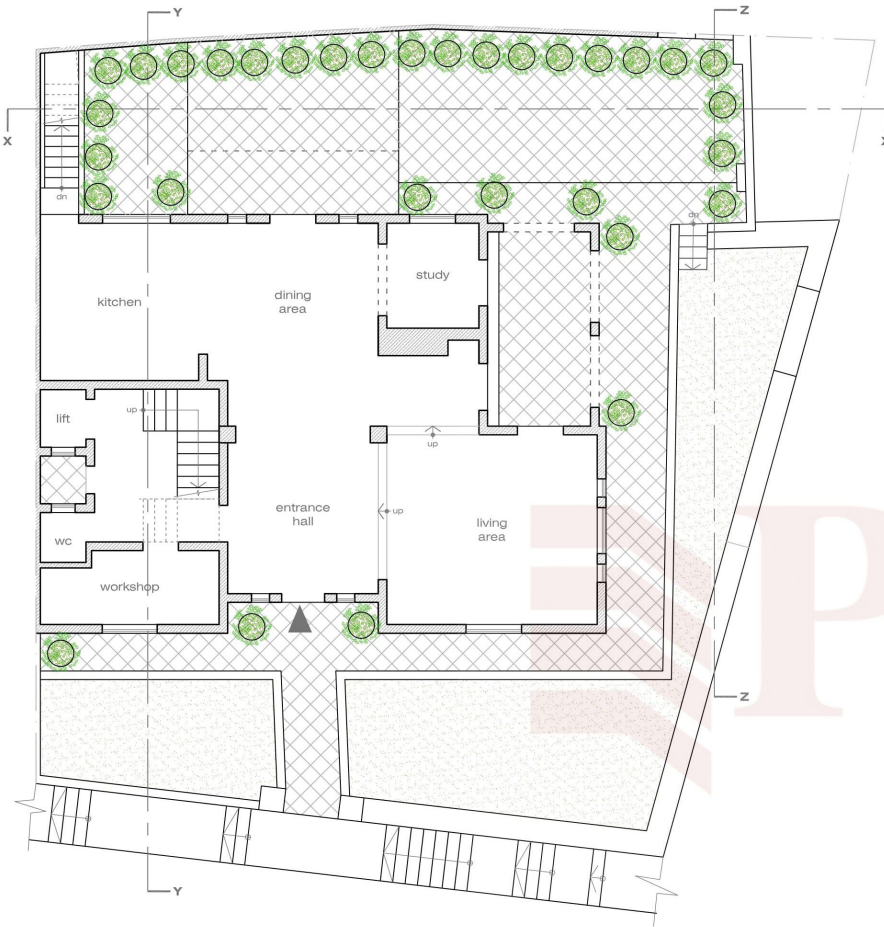

**APPROVED GROUND FLOOR**  
Scale:- 1:100

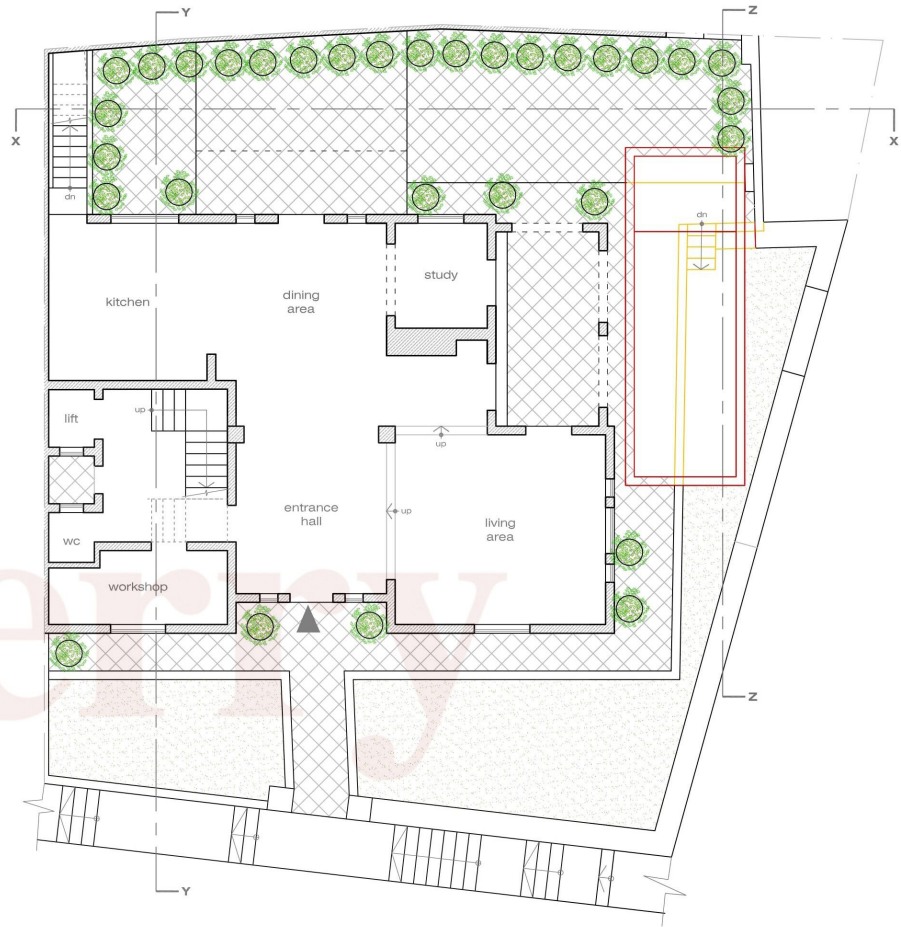

**PROPOSED GROUND FLOOR**  
Scale:- 1:100

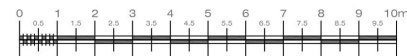


Scale:- 1:100


Color Coding Legend			
	Proposed, to Demolish		
	Proposed, to Construct		
	Sanction, as Constructed		
	Approved, Not Constructed		

PROPOSAL		Existing Plans	
CLIENT		KAPPARA	
SCALE:	1:100	DRAWING NUMBER:	02
DATE:		REVISIONS	00
DRAWN BY:		JOB NUMBER:	PAPER SIZE
			A2


Site Area: 411m<sup>2</sup>  
Area of Soft Landscaping: 82.2m<sup>2</sup>

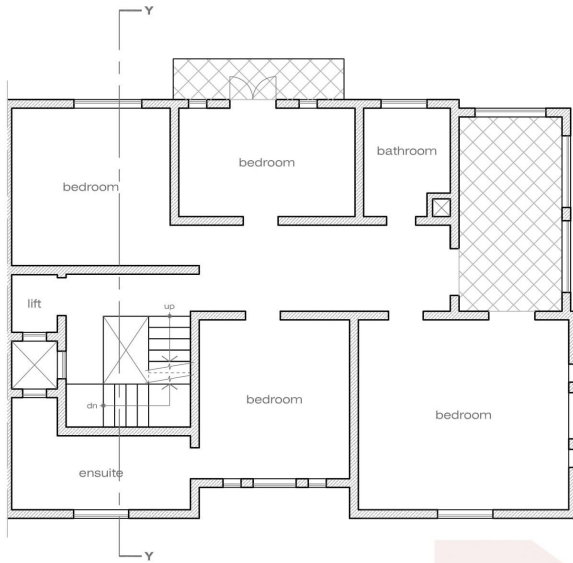


**APPROVED FIRST FLOOR PLAN**  
Scale:- 1:100

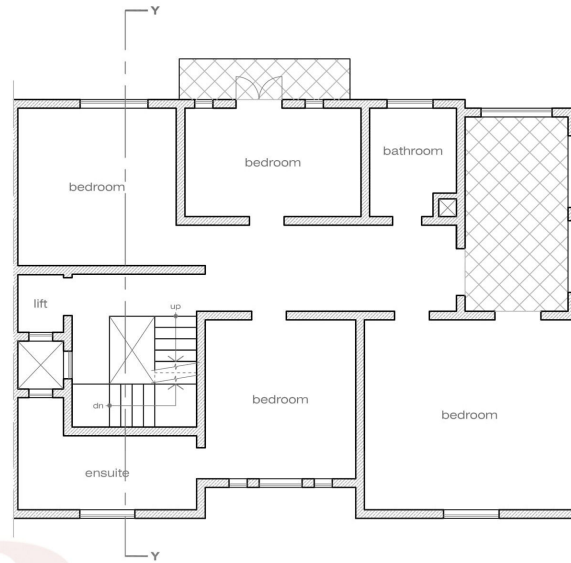


**PROPOSED FIRST FLOOR PLAN - (No Changes)**  
Scale:- 1:100

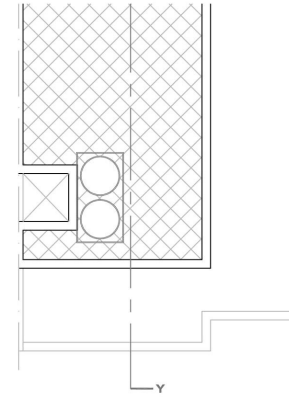

**ROOF LEVEL (No Changes)**  
Scale:- 1:100

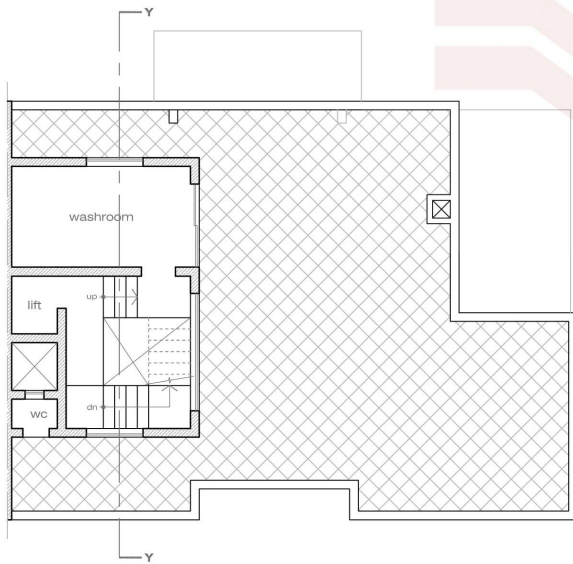

**APPROVED ROOF PLAN**  
Scale:- 1:100

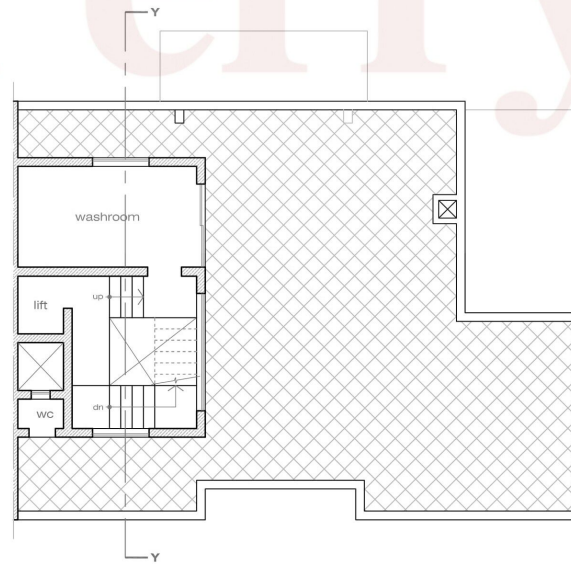

**PROPOSED ROOF PLAN - (No Changes)**  
Scale:- 1:100

**Color Coding Legend**

	Proposed, to Demolish
	Proposed, to Construct
	Sanction, as Constructed
	Approved, Not Constructed



Scale:- 1:100

PROPOSAL	Existing Plans KAPPARA		
CLIENT	W.Muscat		
SCALE:	1:100	DRAWING NUMBER:	03
DATE:	11-03-2015	REVISIONS	00
DRAWN BY:	c.p.	JOB NUMBER:	****/14
		PAPER SIZE	A2