


1 As Approved Semi-Basement (as per PA/01112/1) Plan
Scale 1:100

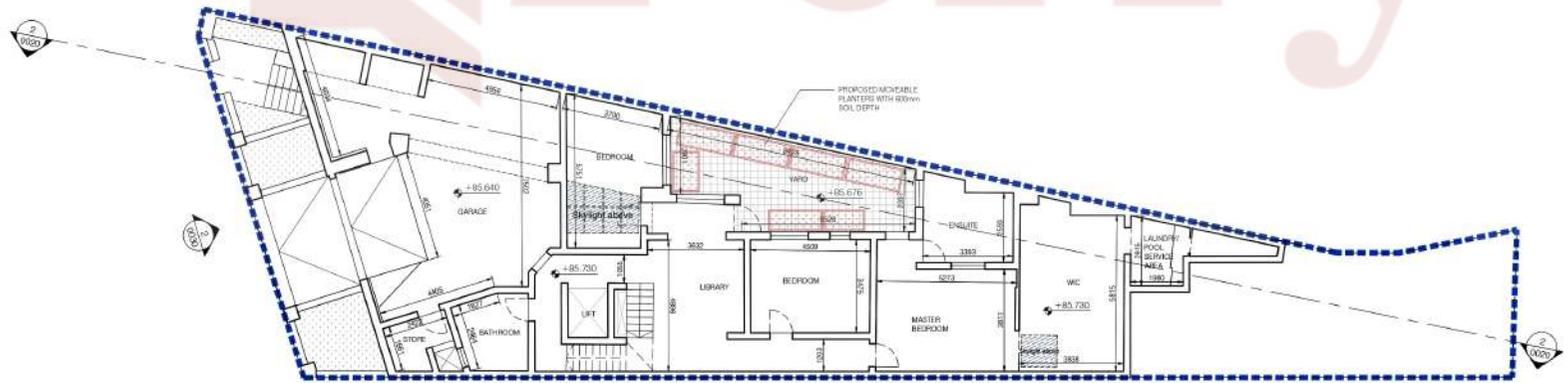

2 As Built & Proposed Semi-Basement Plan
Scale 1:100

Issued for PA

Legend:

- As Approved But Not Built
- As Constructed But Not Approved
- As Proposed To Construct

Notes:

1. All Dimensions are in mm unless otherwise indicated.
2. Contractor is to check dimensions before construction. Any discrepancies arising from failure of doing so will be deemed to be the responsibility of the contractor, and any claims for damages will be rejected.

Rev	Date	By	Description

