


1 As Approved Ground Floor (as per PA/0112/11)  
Plan  
Scale 1:100

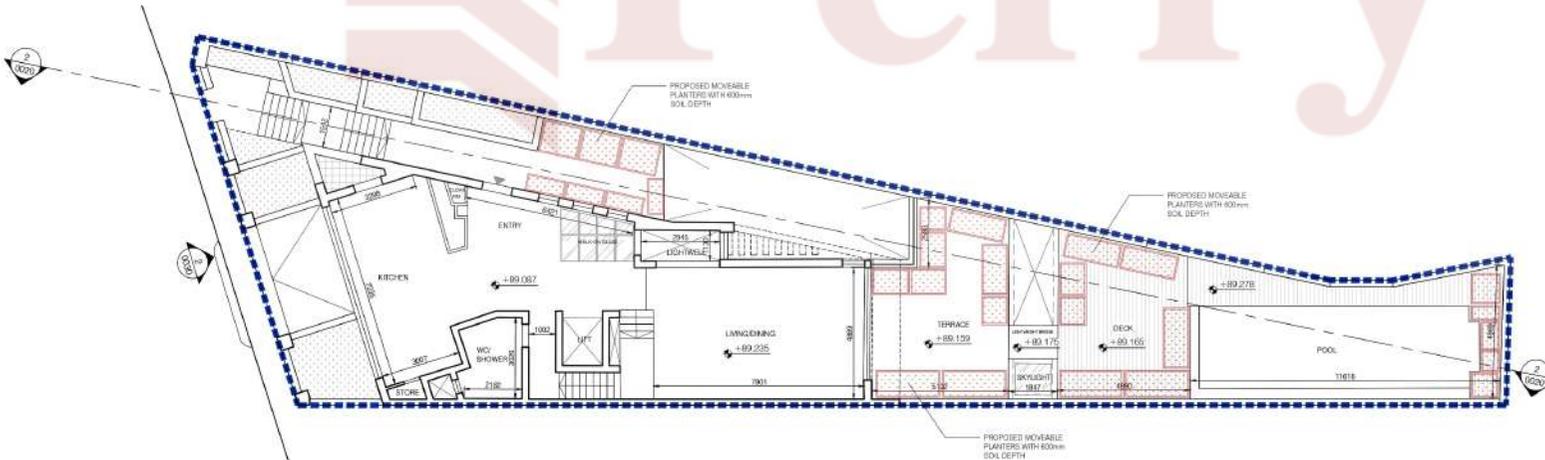

2 As Built & Proposed Ground Floor  
Plan  
Scale 1:100

Issued for PA

- Legend:
- As Approved But Not Built
  - As Constructed But Not Approved
  - As Proposed To Construct

- Notes:
1. All Dimensions are in mm unless otherwise indicated.
  2. Contractor is to check dimensions before construction. Any discrepancies arising from failure of doing so shall be deemed to be the responsibility of the contractor, and any claims for damages will be rejected.

Rev	Date	By	Description

