



Approved ground floor

Scale 1:100

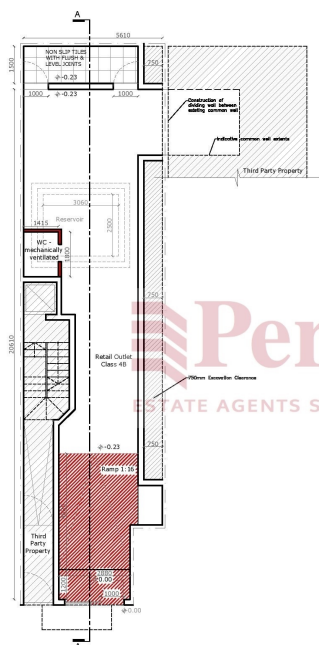


Proposed ground floor plan

Scale 1:100

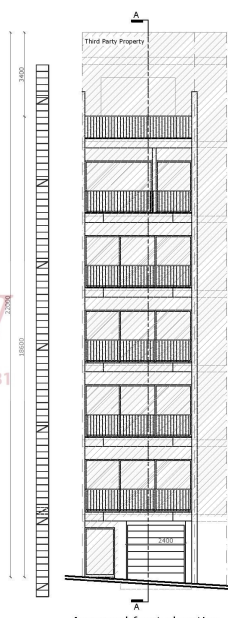

Approved front elevation

Scale 1:100

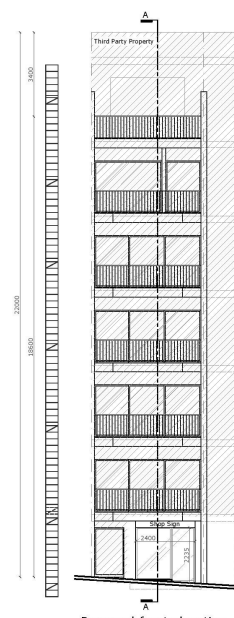

Proposed front elevation

Scale 1:100

Proposed Materials:  
1. uPVC & glass shop aperture  
2. Composite aluminium lettering of company



- To Construct
- As built to sanction
- To Demolish
- As approved not constructed