HT500021

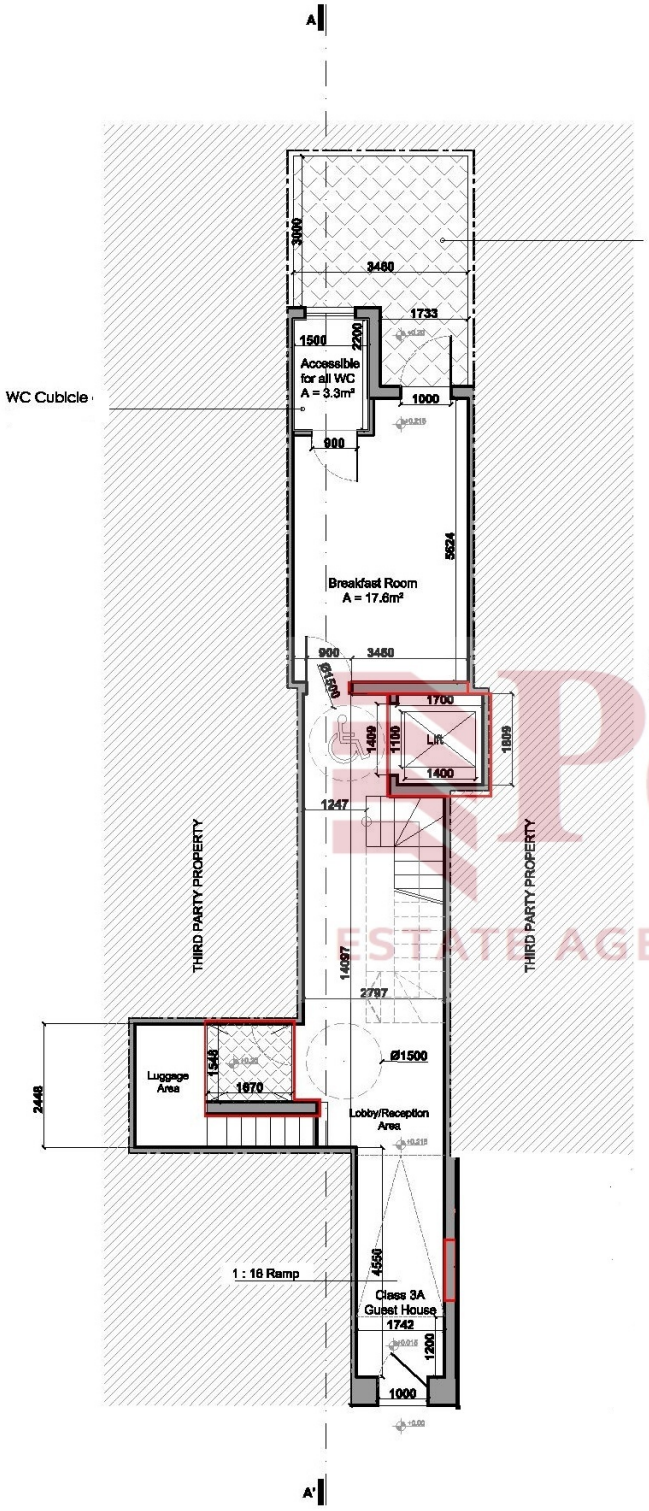

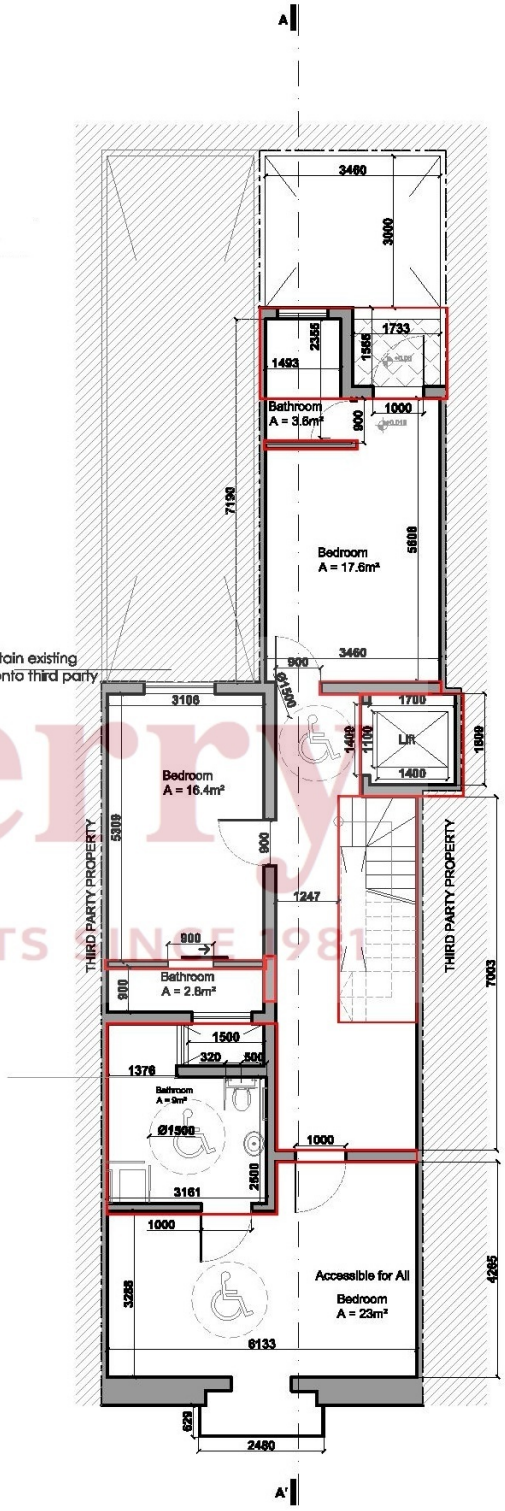

Perry
ESTATE AGENTS SINCE 1981

LEGEND

- As Existing
- As Proposed
- As Approved
- As Constructed

Proposed Ground Floor Plan
Scale 1:100

Proposed First Floor Plan
Scale 1:100

1:100 0 1.00m 2.00m 3.00m 4.00m 5.00m
1:1000 0 10m 20m 30m 40m 50m