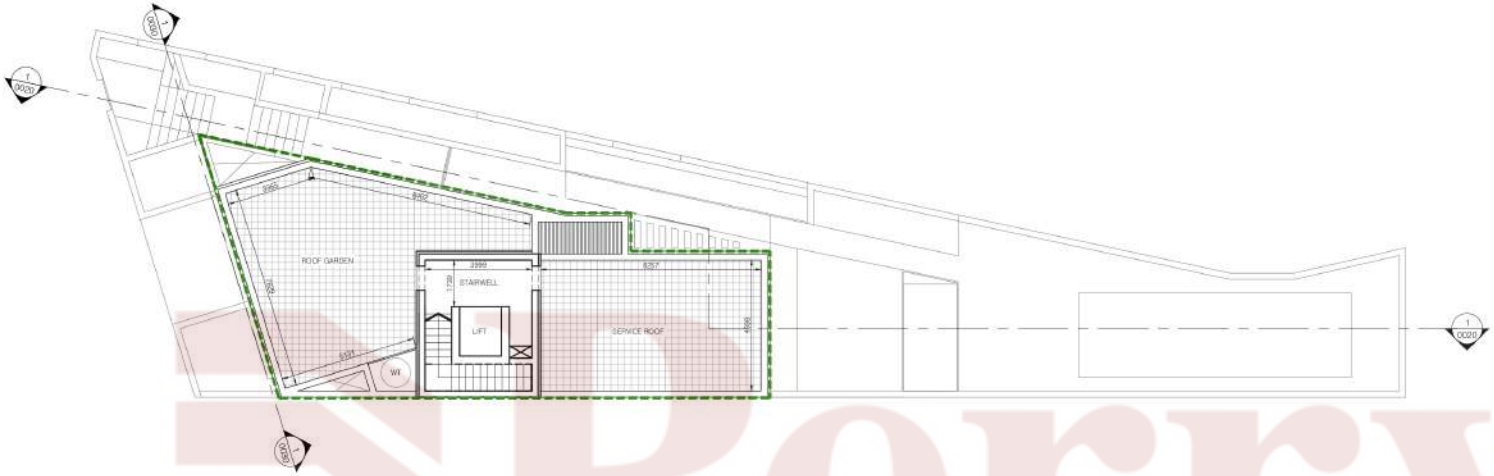

1 As Approved Roof (as per PA/01112/11) Plan
Scale 1:100

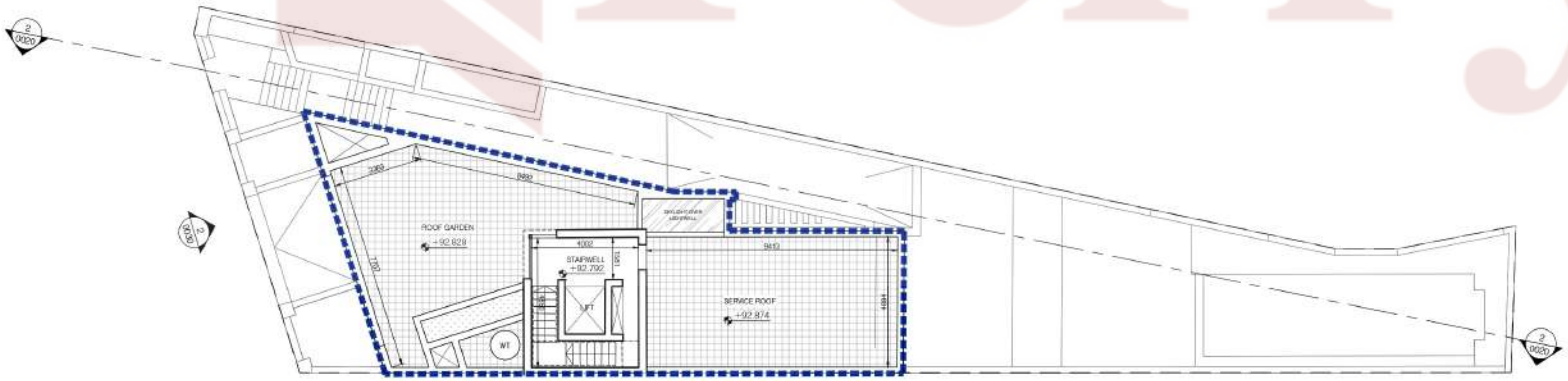

2 As Built Roof Plan
Scale 1:100

Issued for PA

Legend:

As Approved But Not Built

As Constructed But Not Approved

Notes:

1. All Dimensions are in mm unless otherwise indicated.
2. Contractor is to check dimensions before construction. Any discrepancies arising from failure of doing so will be deemed to be the responsibility of the contractor, and any claims for damages will be rejected.

Rev	Date	By	Description

1 0 1 2 3 4 5 6 7 8 9 10m
0.5
Scale 1:100

© This drawing remains the property of the Architect and must not be used or copied without written permission.